



NORTHCHASE CENTER
14550 TORREY CHASE
HOUSTON, TEXAS

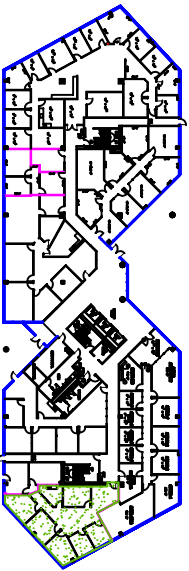

SUITE 190
1,907 NRA
11/18/15

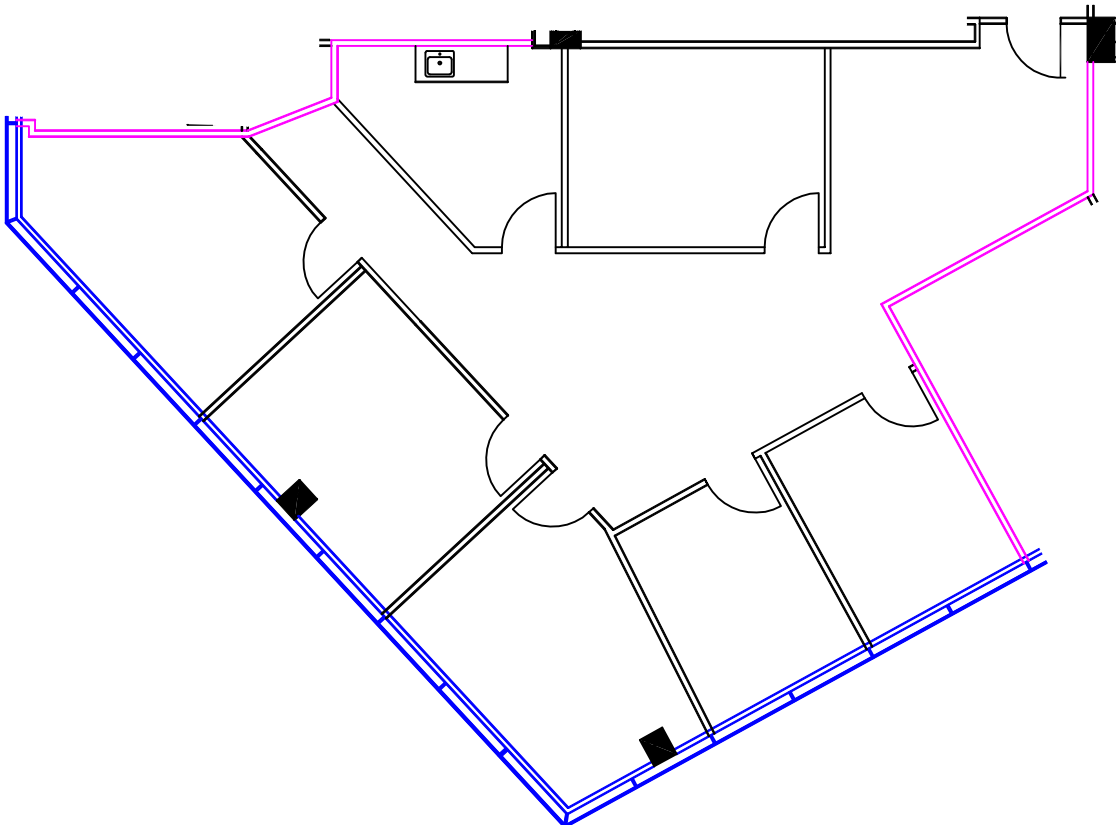

HARTMAN MANAGEMENT
2909 HILLCROFT
SUITE 420
HOUSTON, TX 77057